

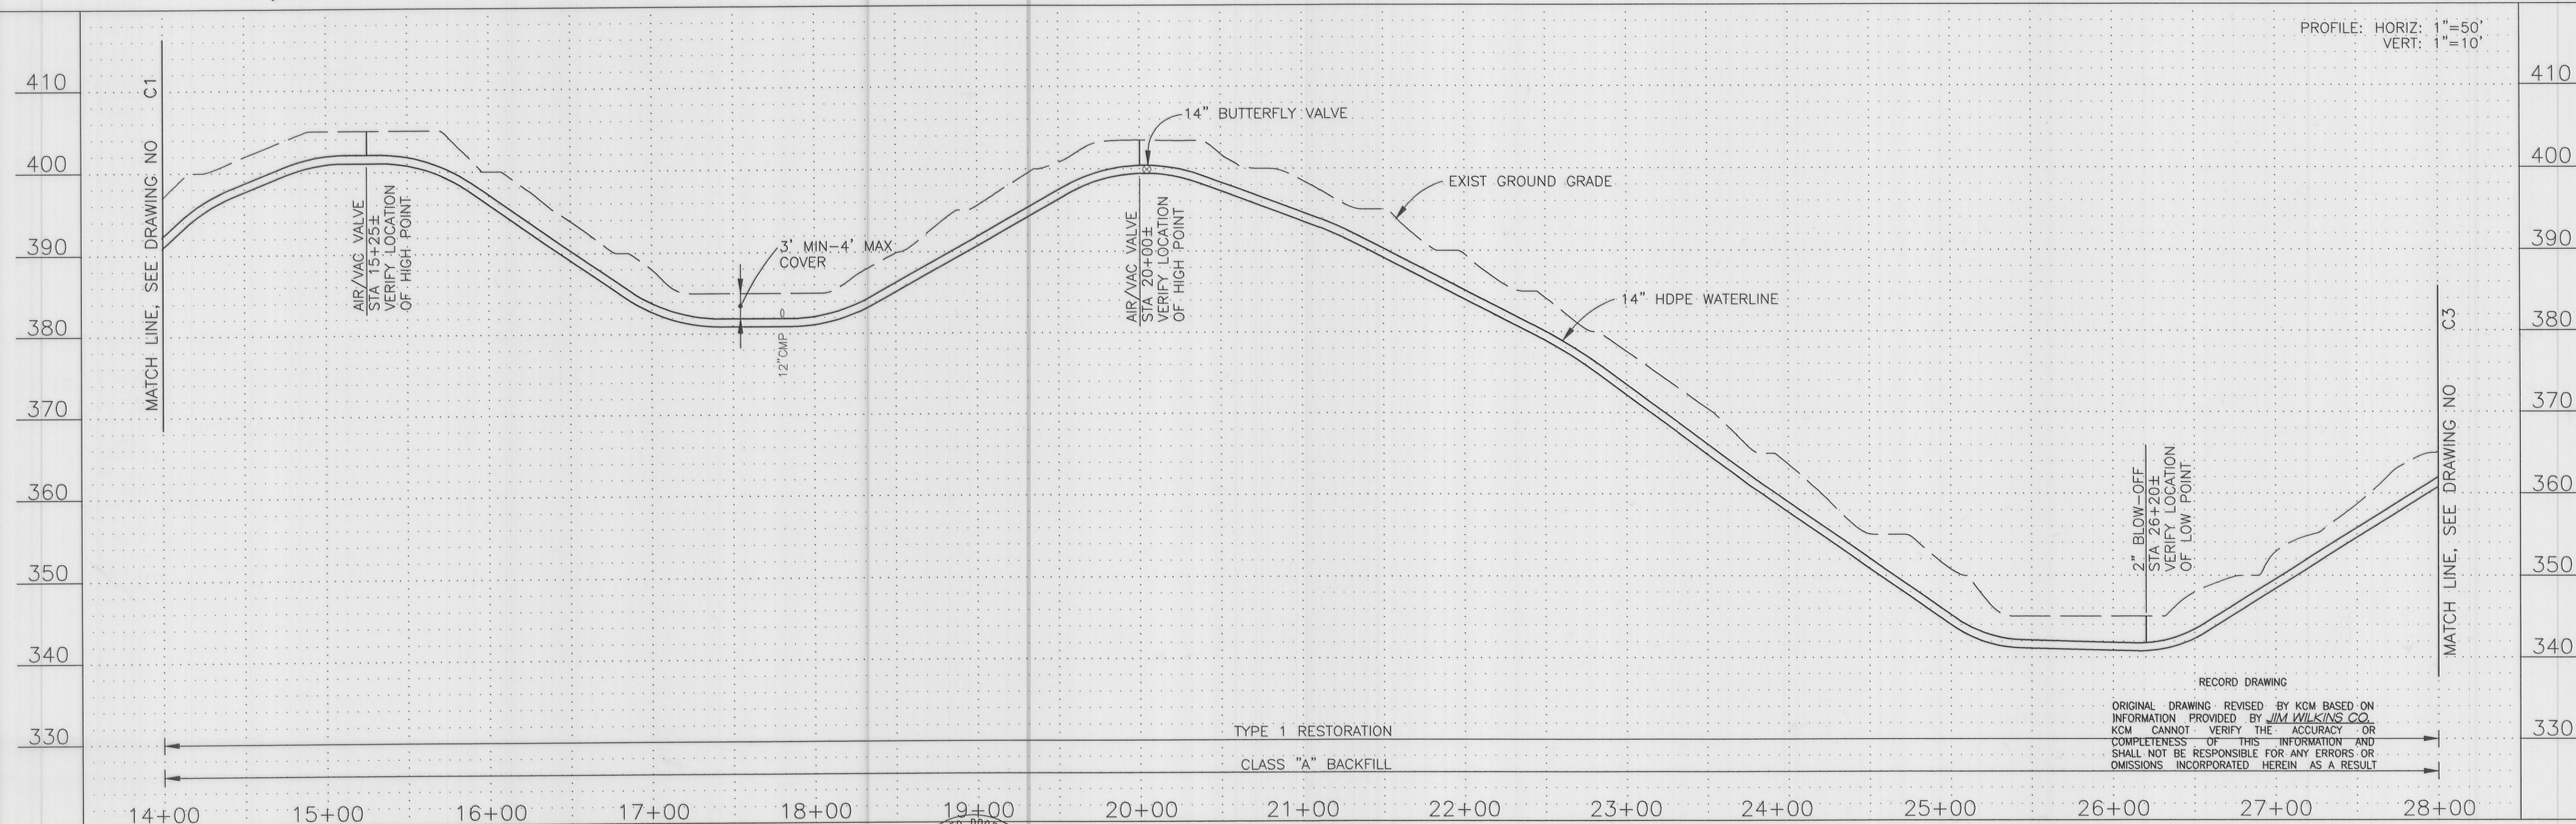


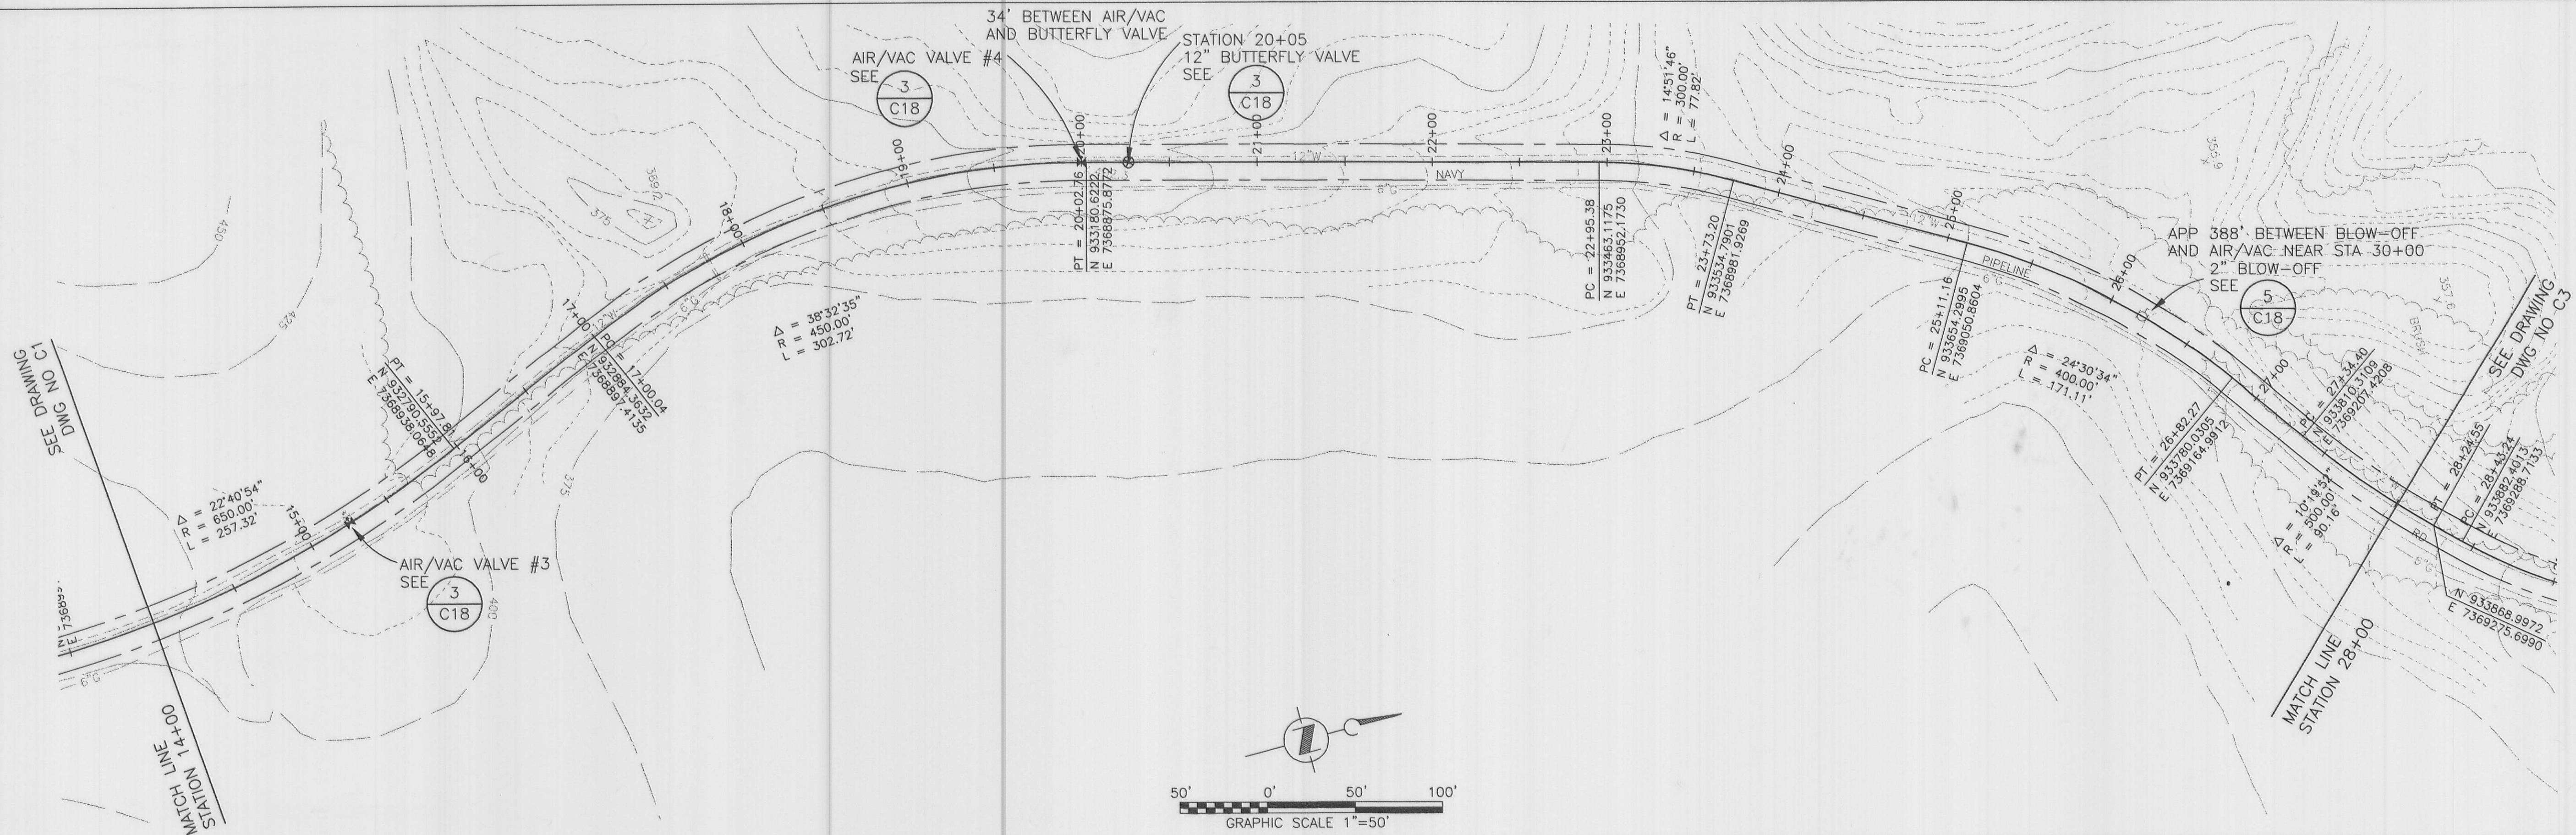

KCM KCM, Inc.
7080 SW Fir Loop
Portland, Oregon 97223

date	designed by
JUNE 1997	RAB, SEL
scale	drawn by
AS NOTED	SEL
	checked by
	RAB
	approved by

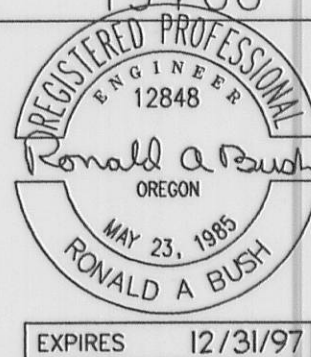

revisions
KCM NO. 2685026

City of Astoria, Oregon
EAST ASTORIA WATERLINE

CIVIL
PLAN / PROFILE STA 14+00 TO 28+00

drawing number
C2
sheet number
4 of 23

RECORD DRAWING
ORIGINAL DRAWING REVISED BY KCM BASED ON INFORMATION PROVIDED BY JIM WILKINS CO. KCM CANNOT VERIFY THE ACCURACY OR COMPLETENESS OF THIS INFORMATION AND SHALL NOT BE RESPONSIBLE FOR ANY ERRORS OR OMISSIONS INCORPORATED HEREIN AS A RESULT

50262 1"=50' 2685026 6.18.97 +ASTORIASURVEY\PROFMAIN-ROTATION\2685

This drawing is full size when 22"x 34" or is reduced to half size when 11"x17"